

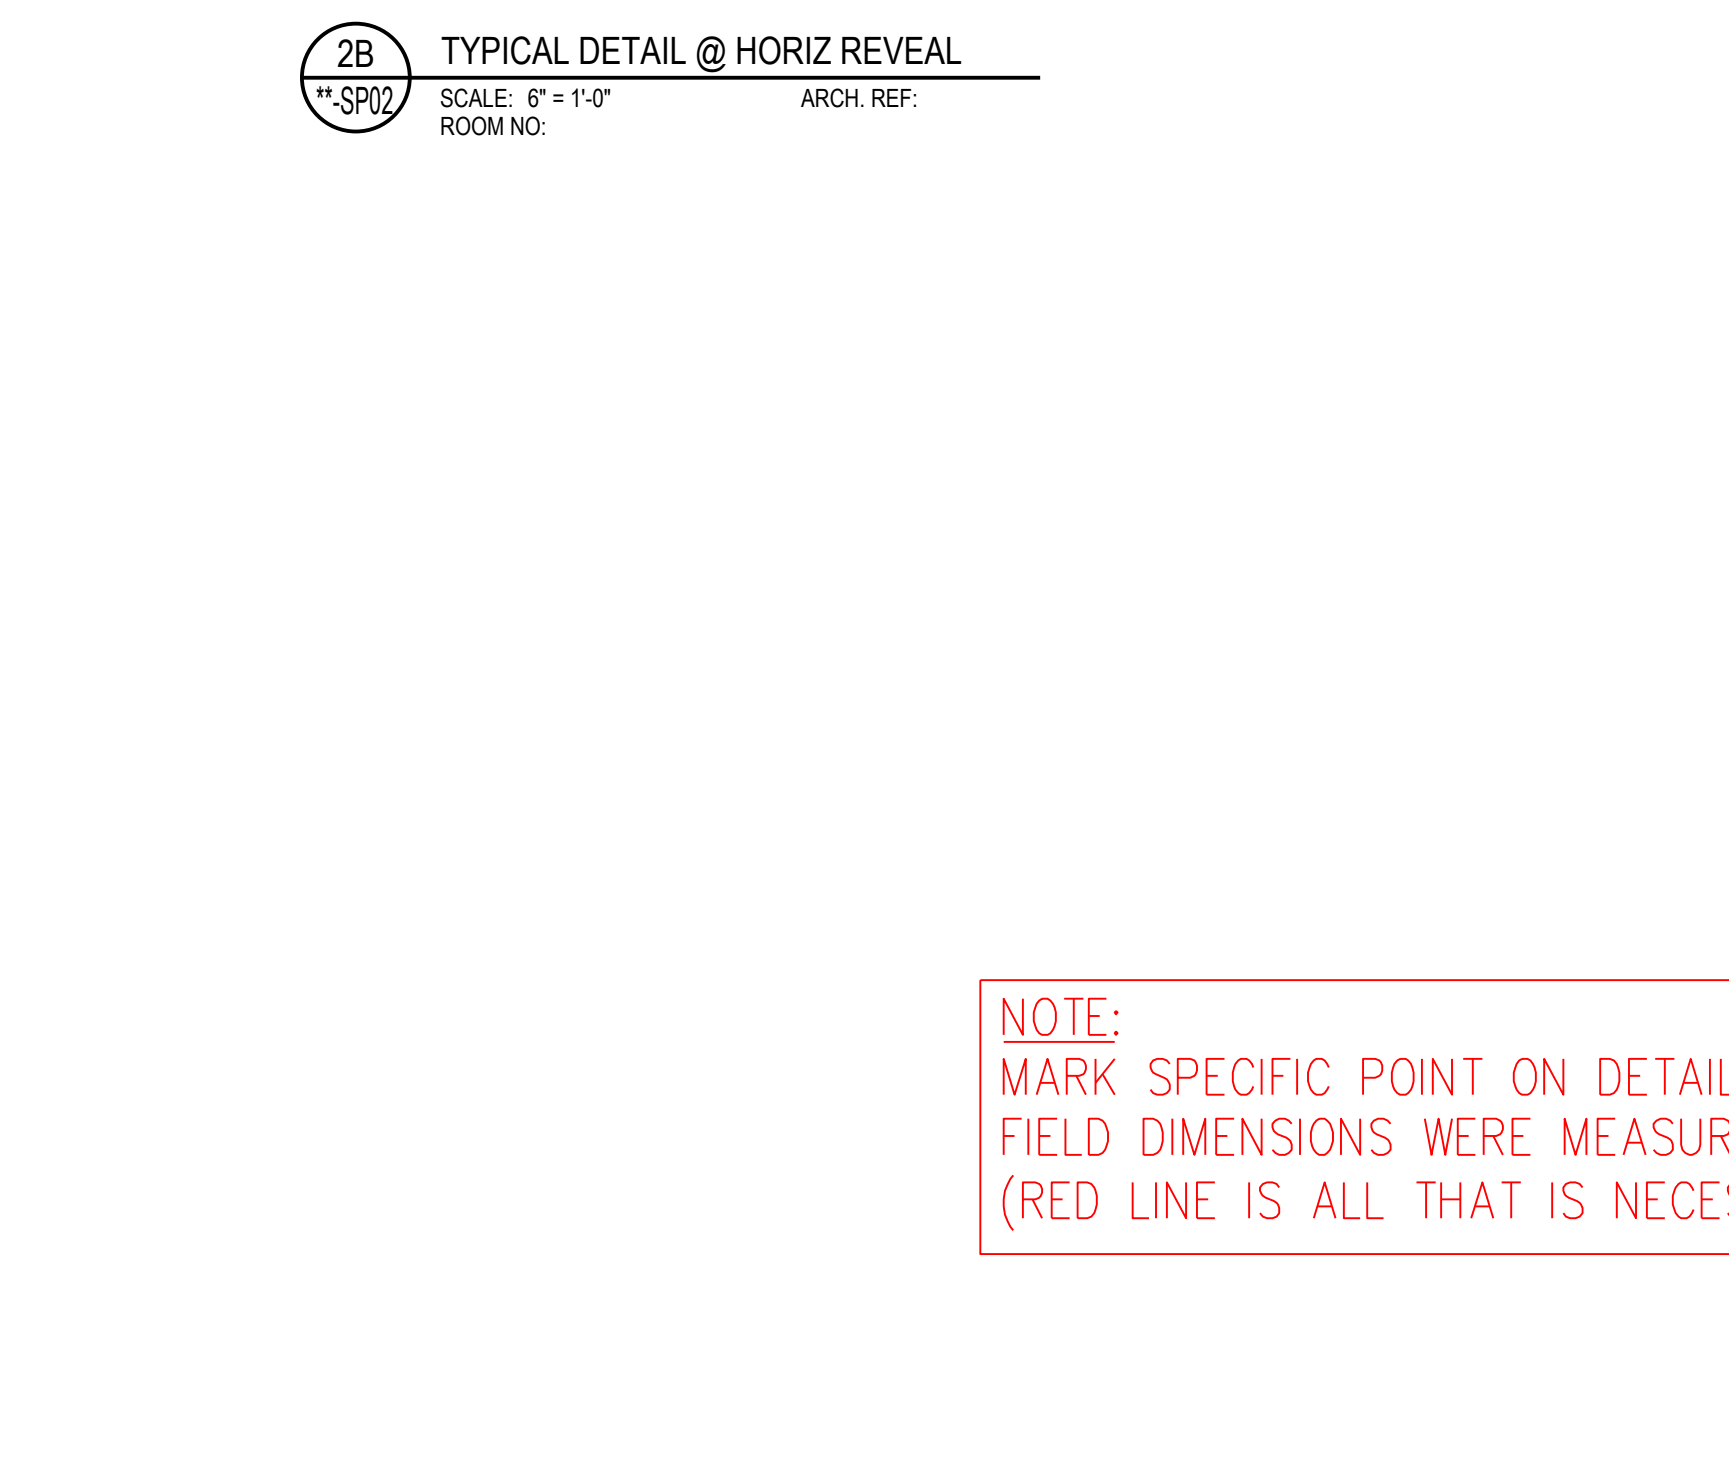
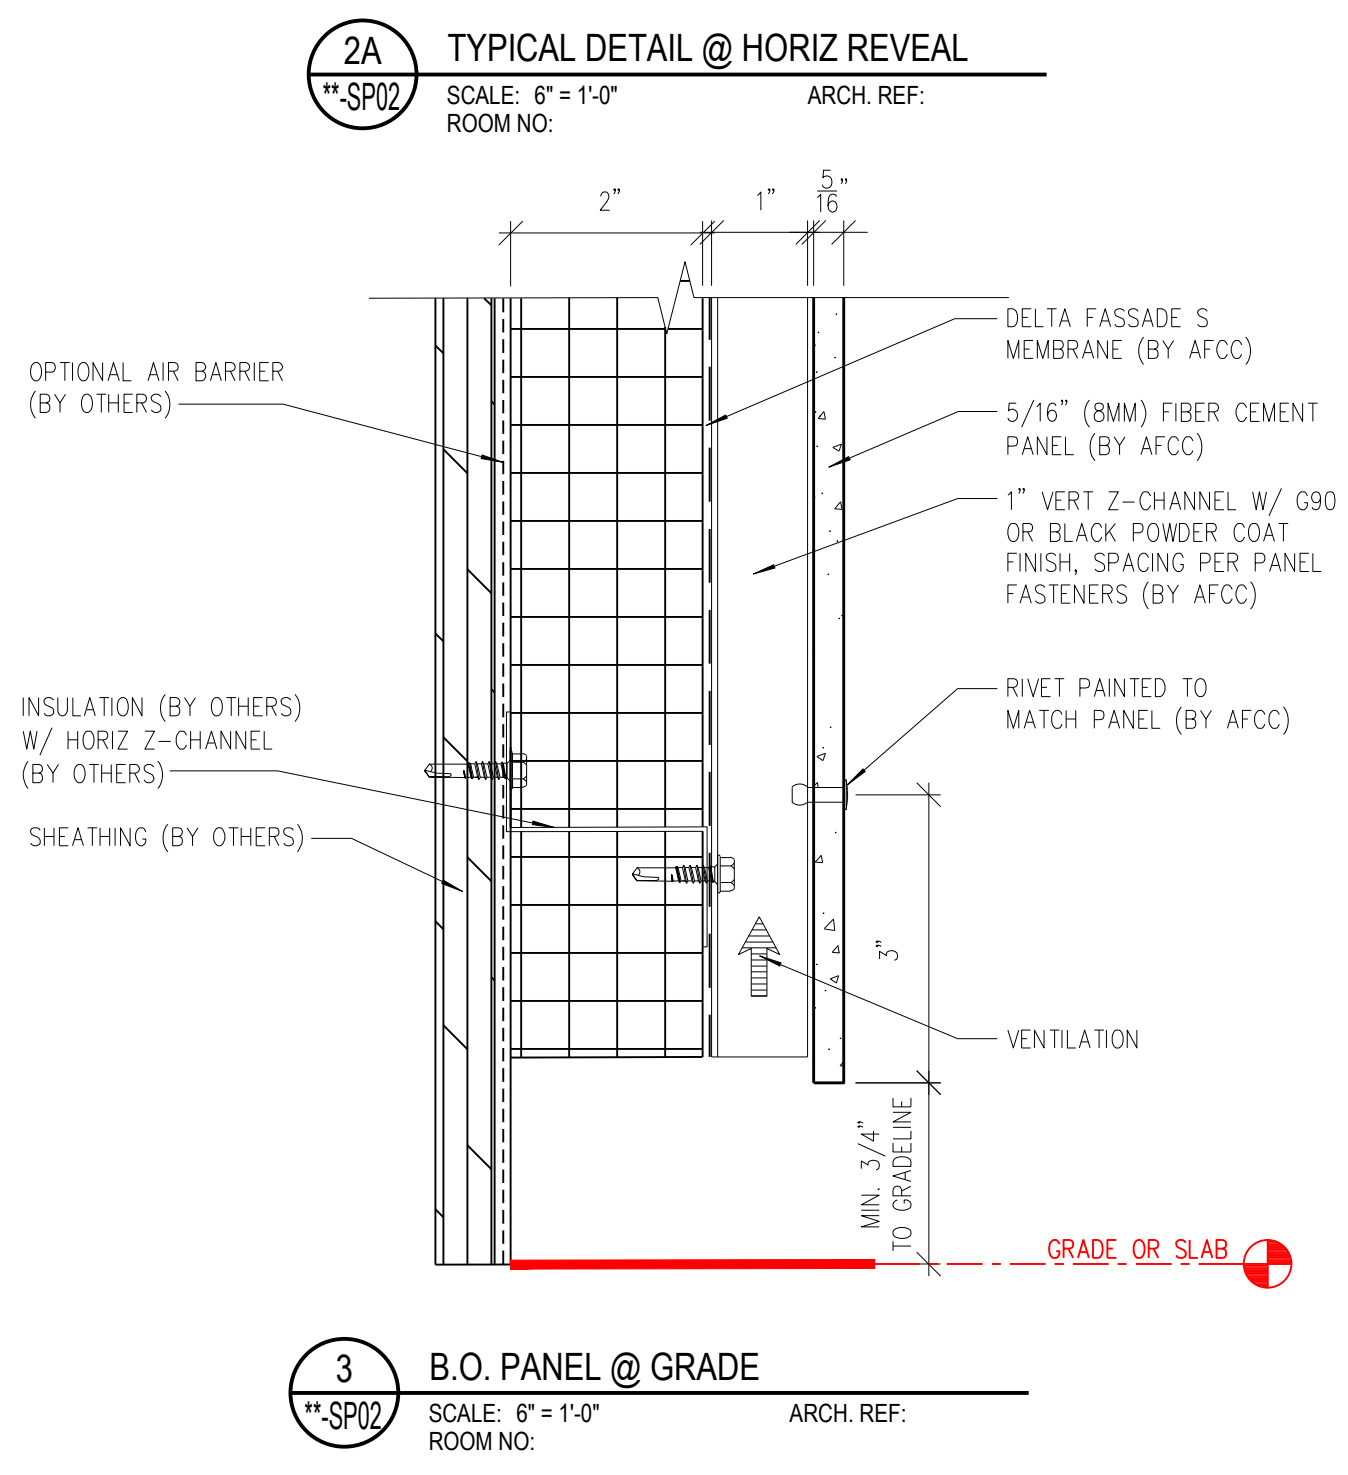
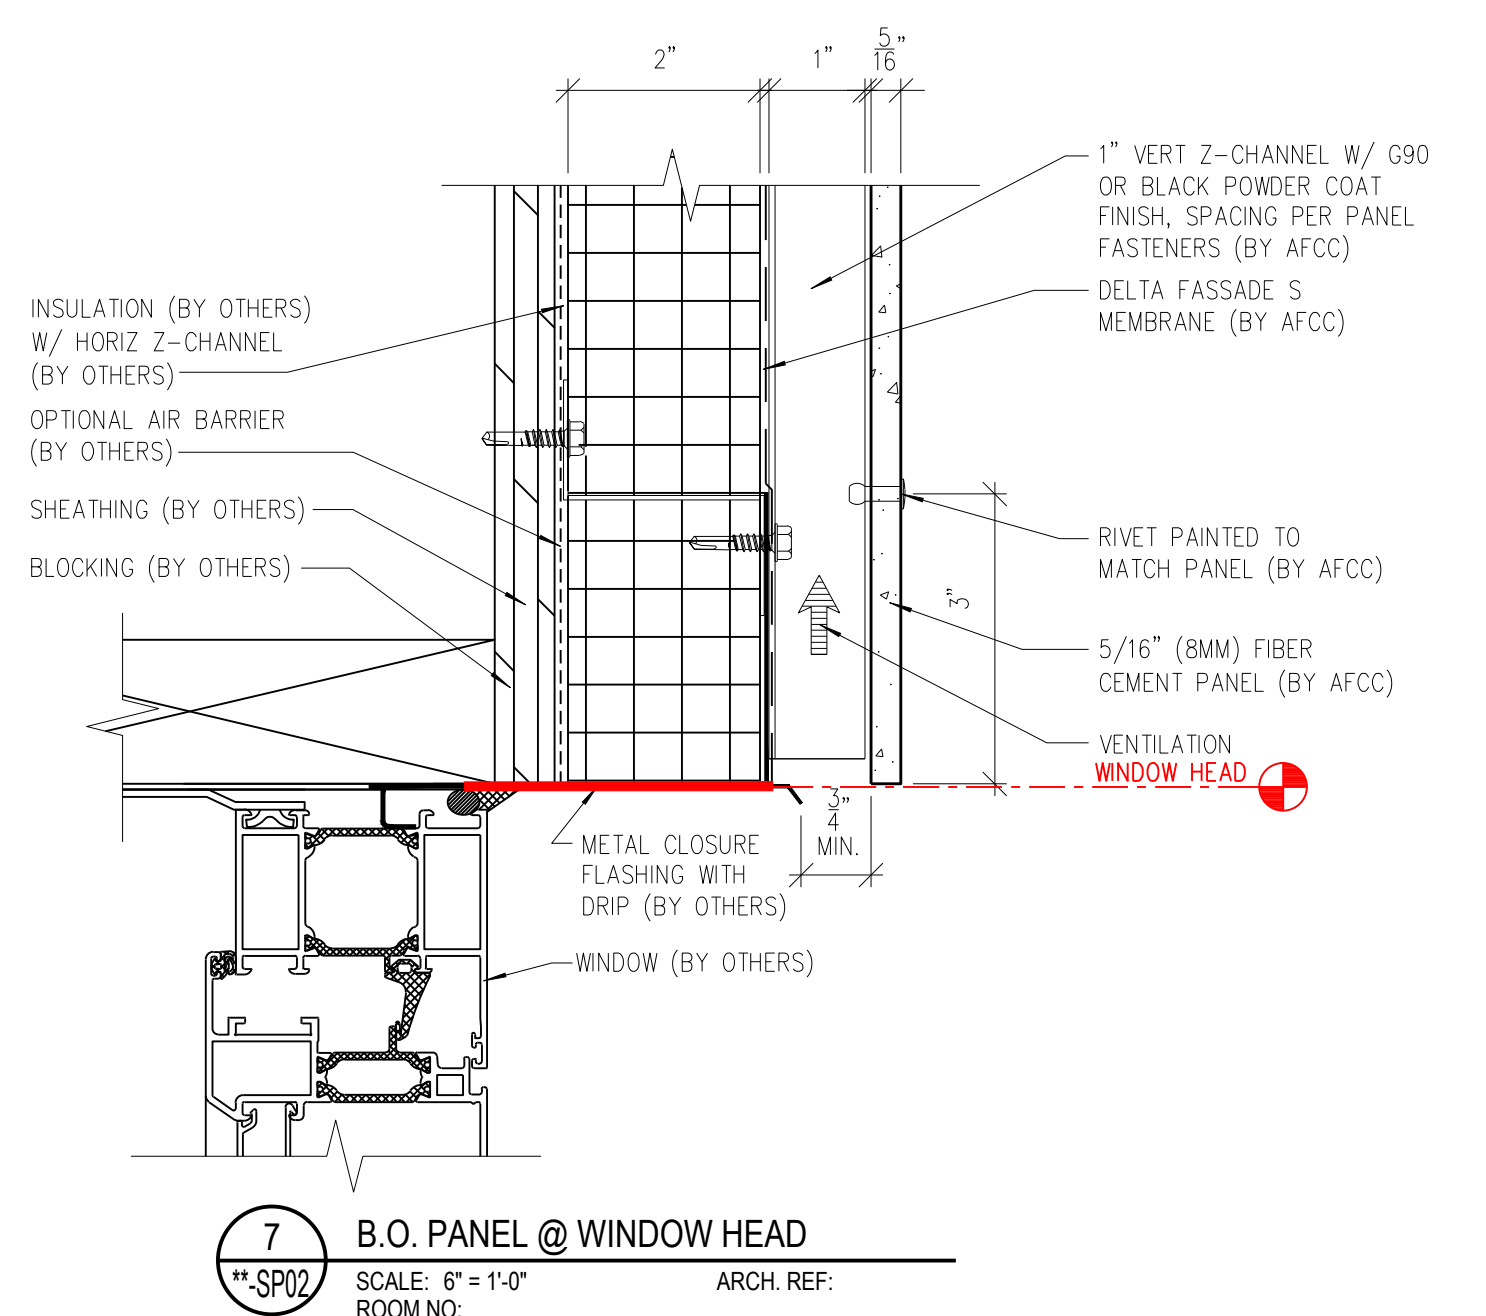
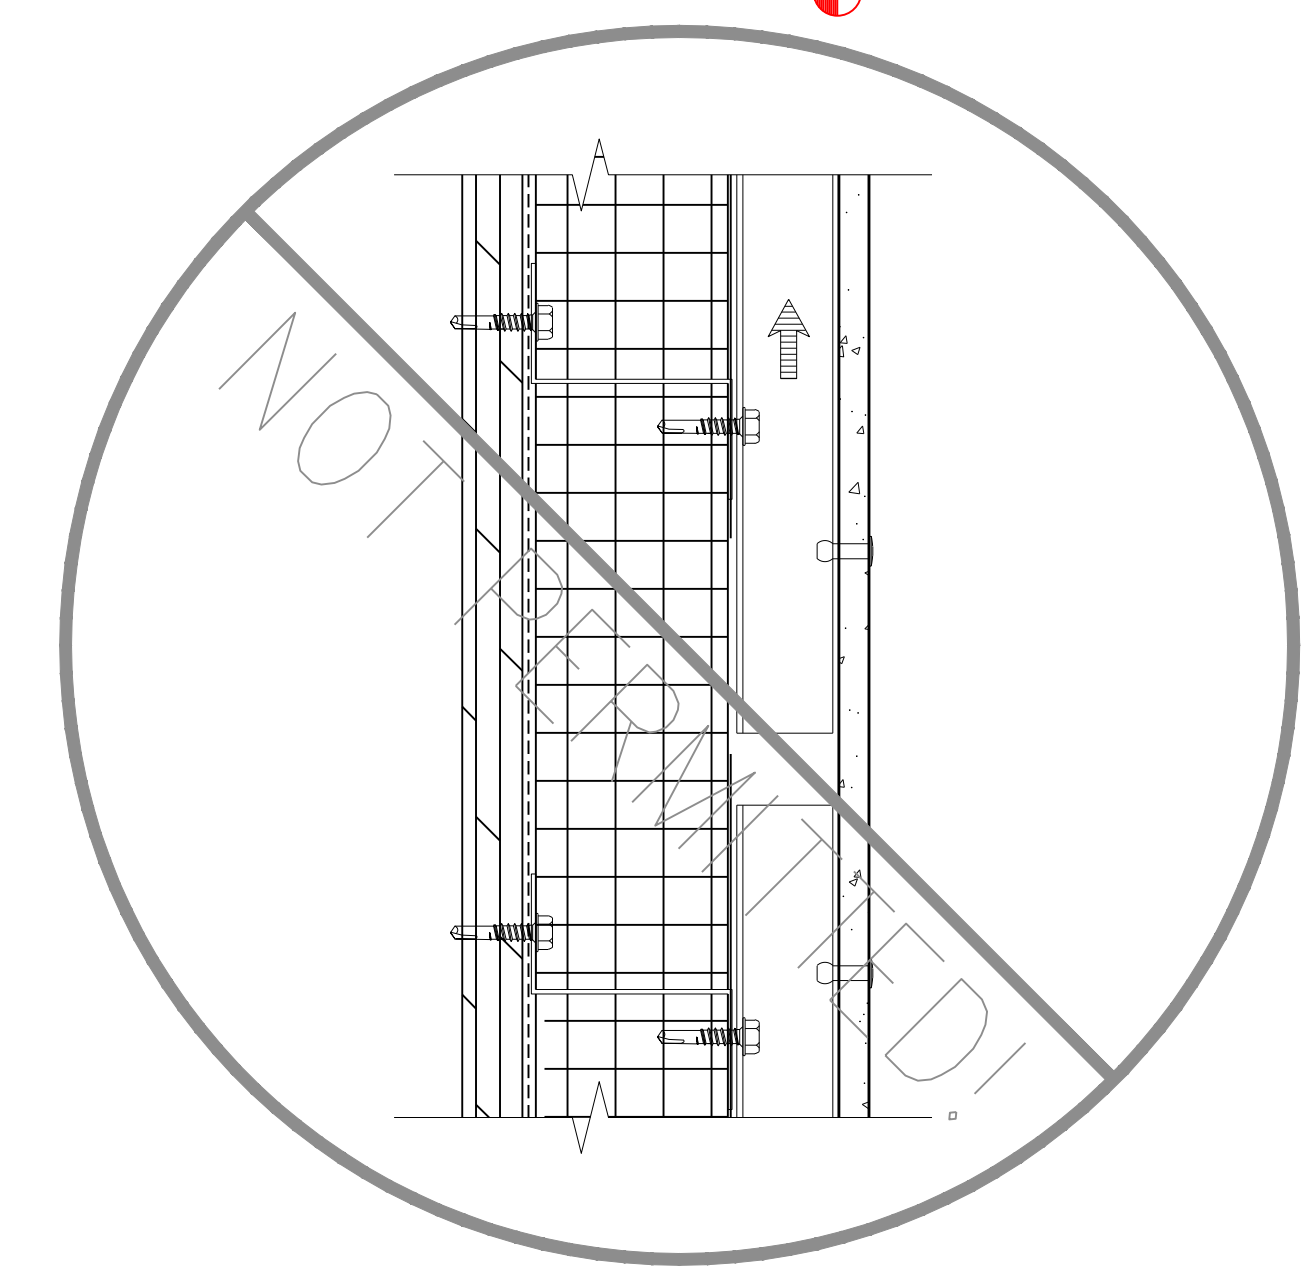
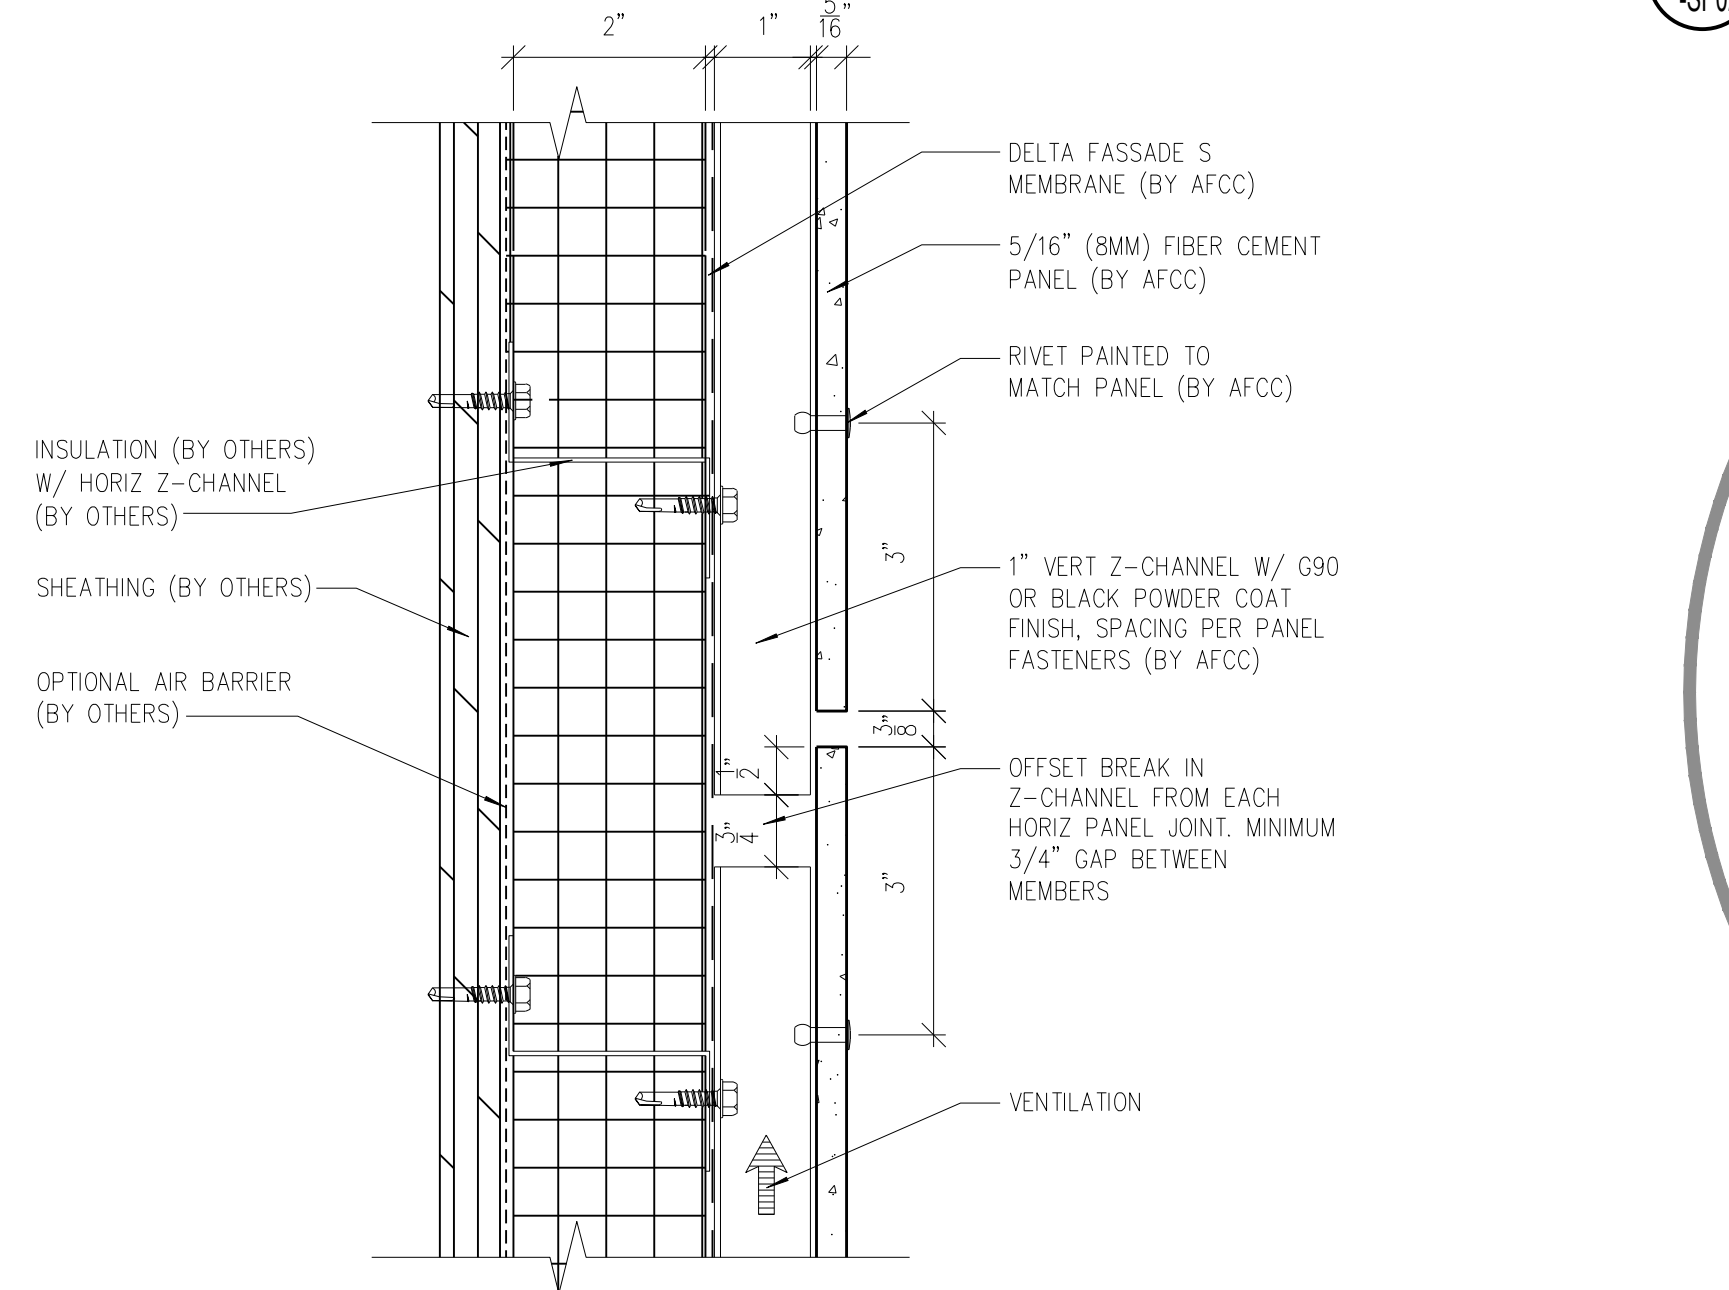
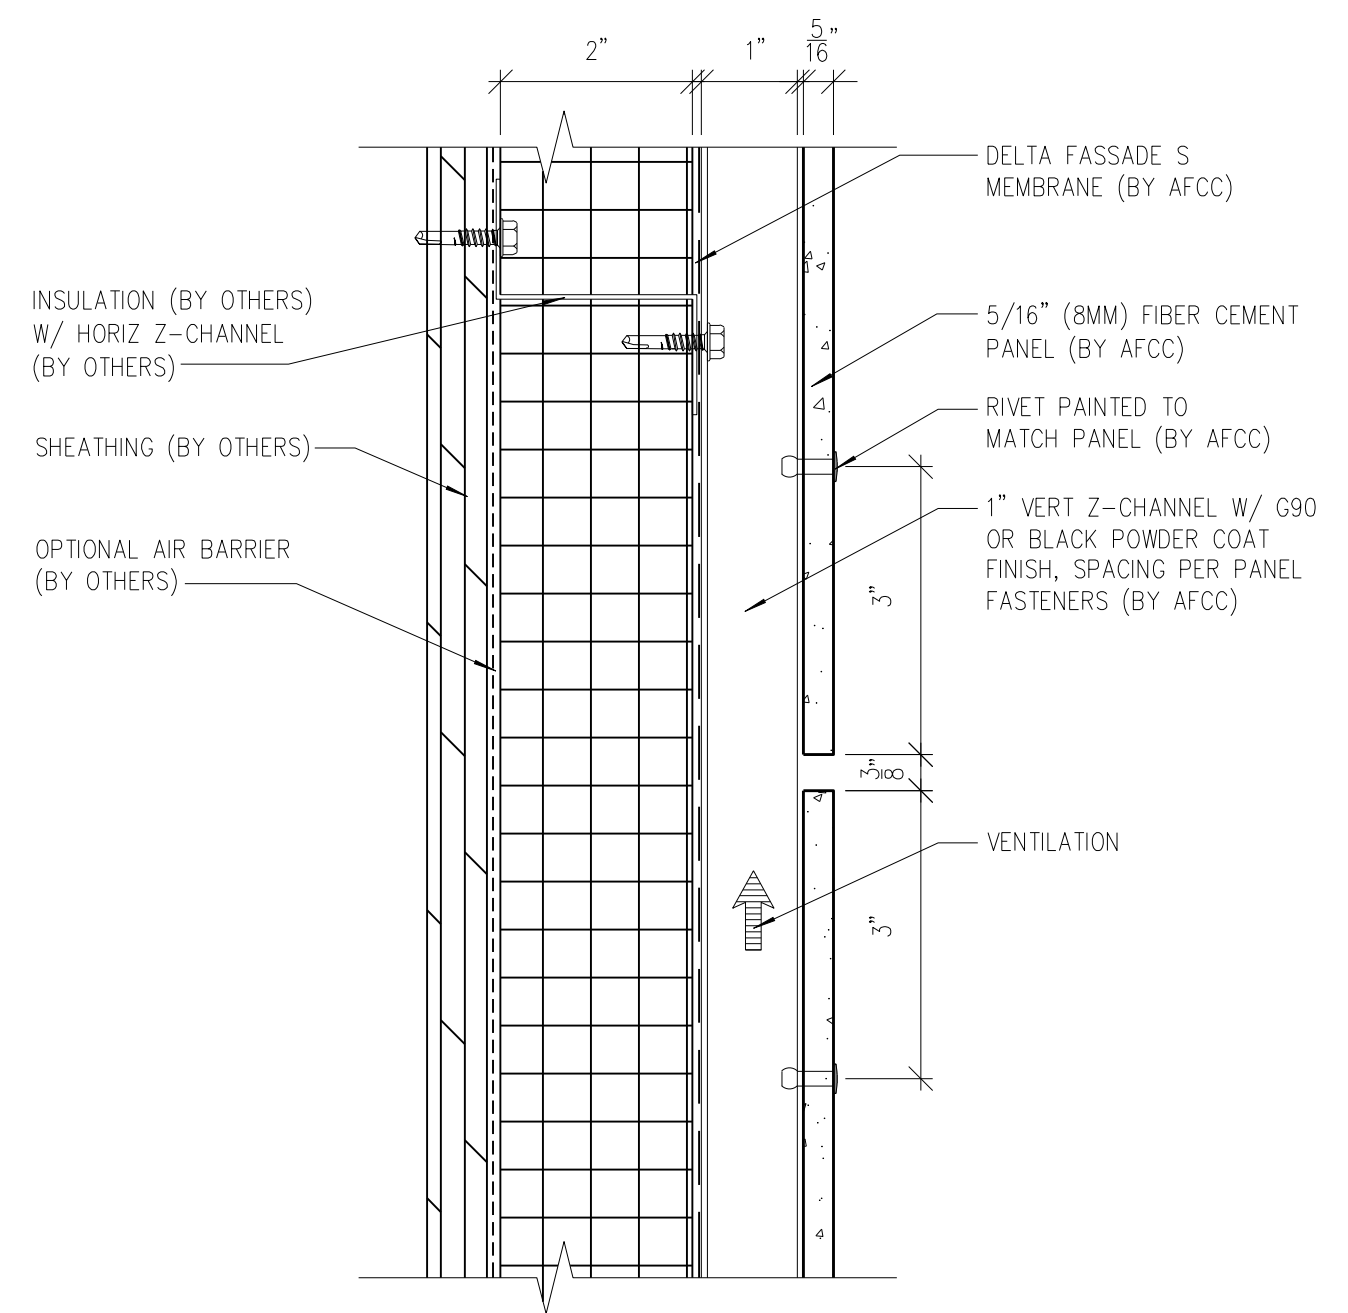
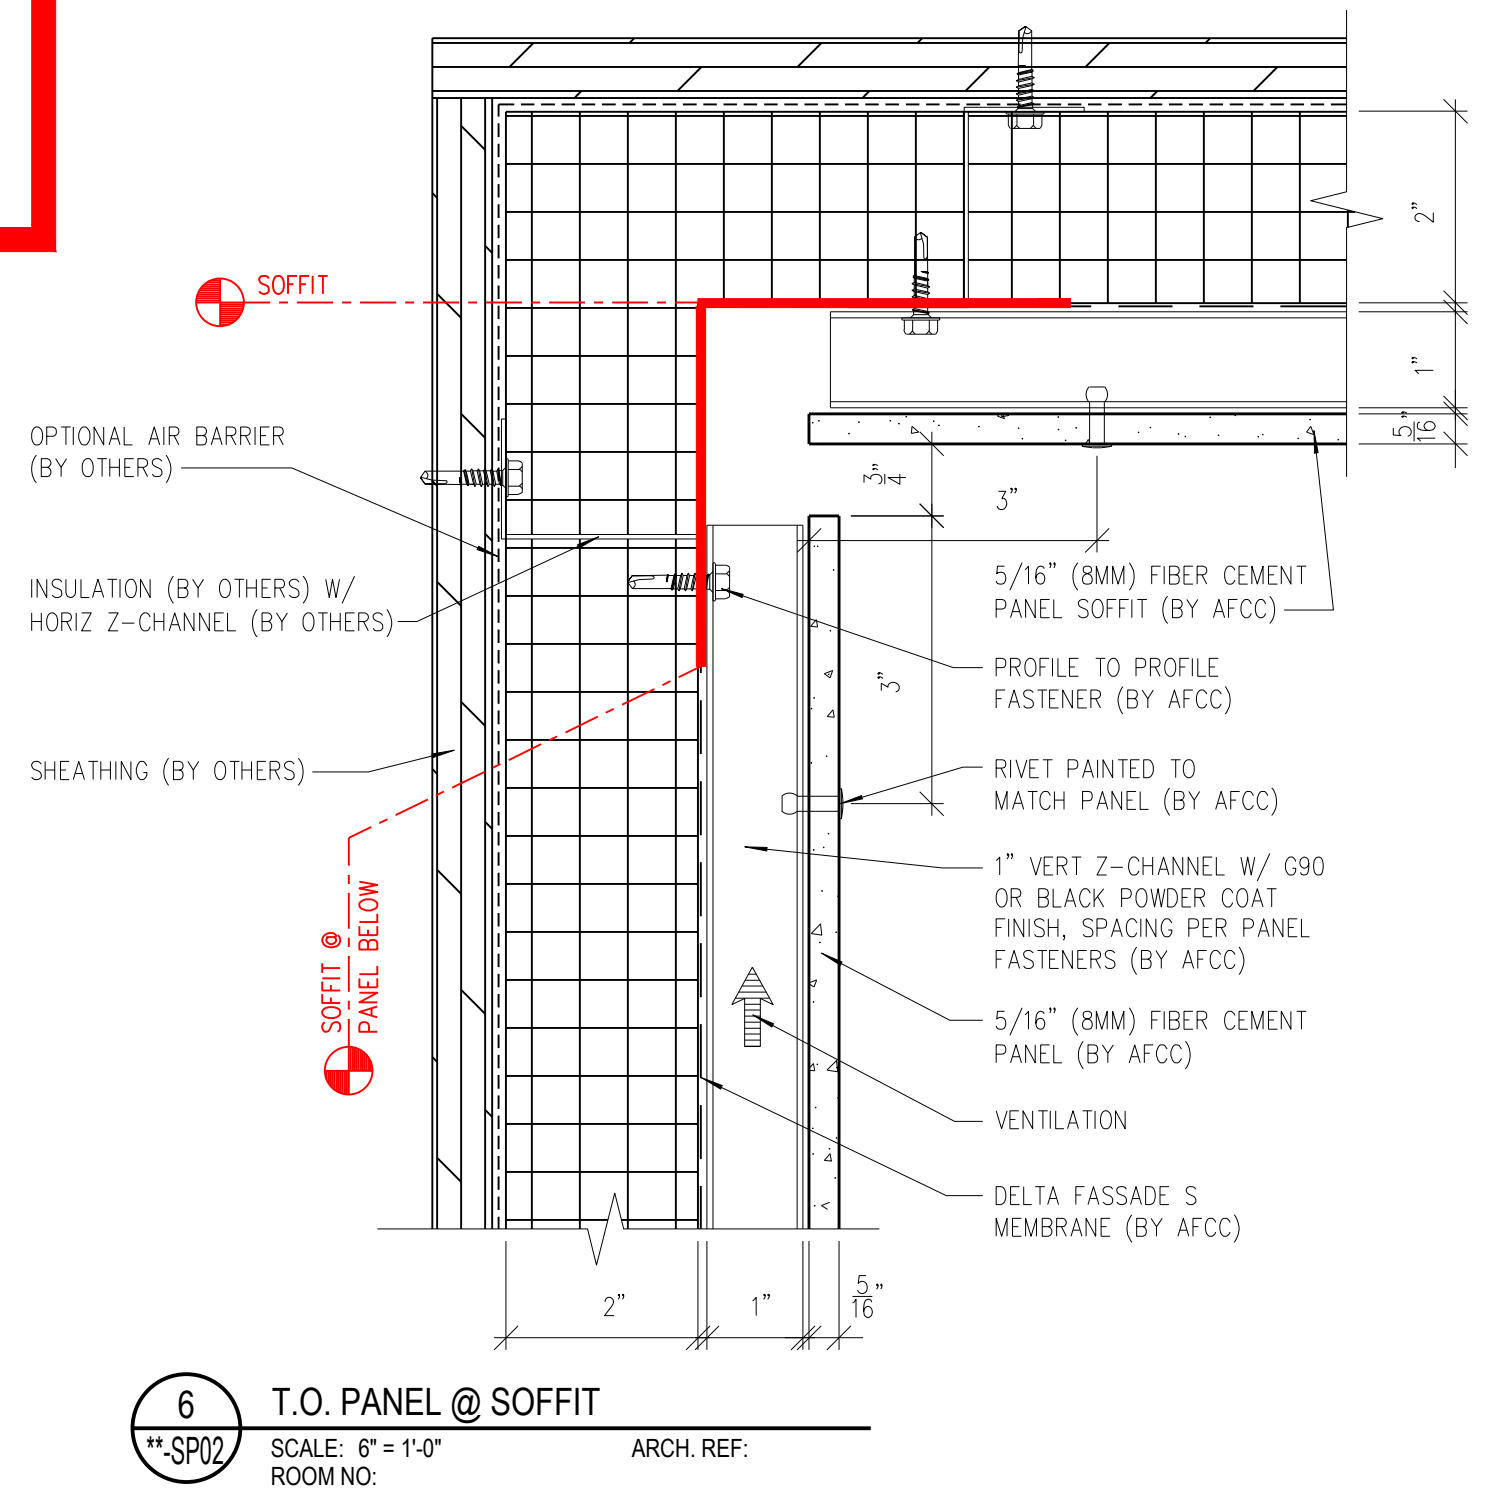
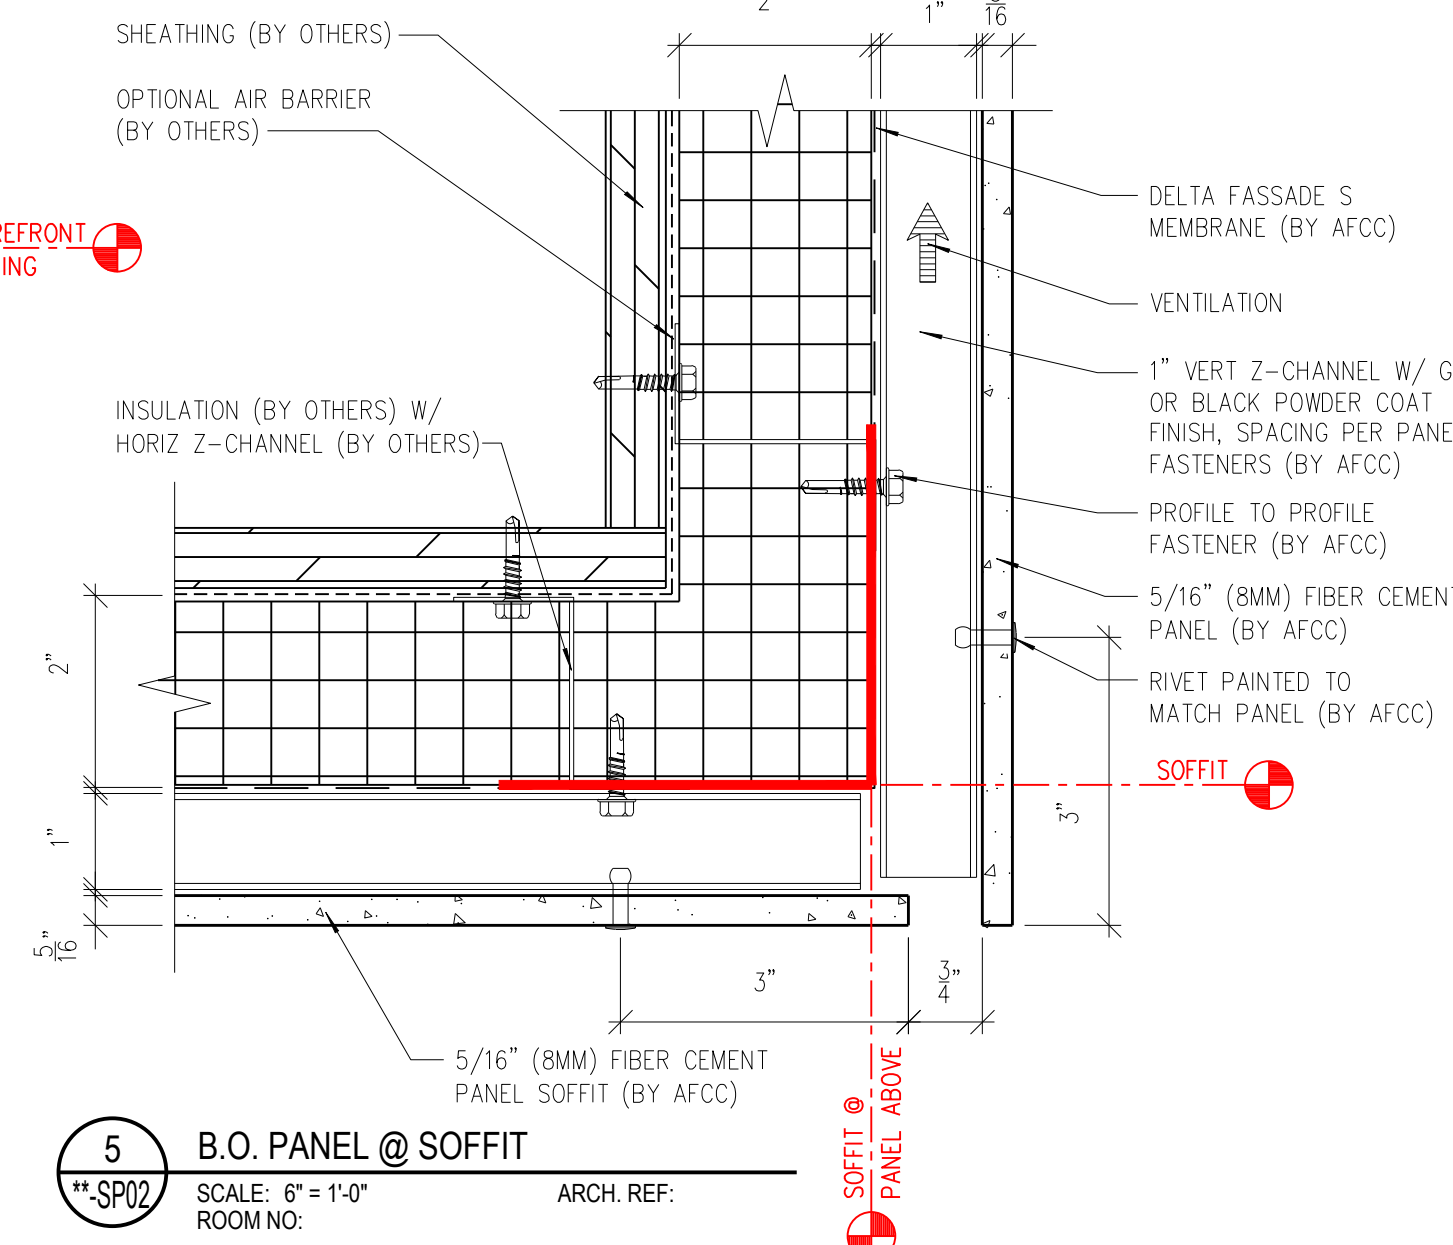


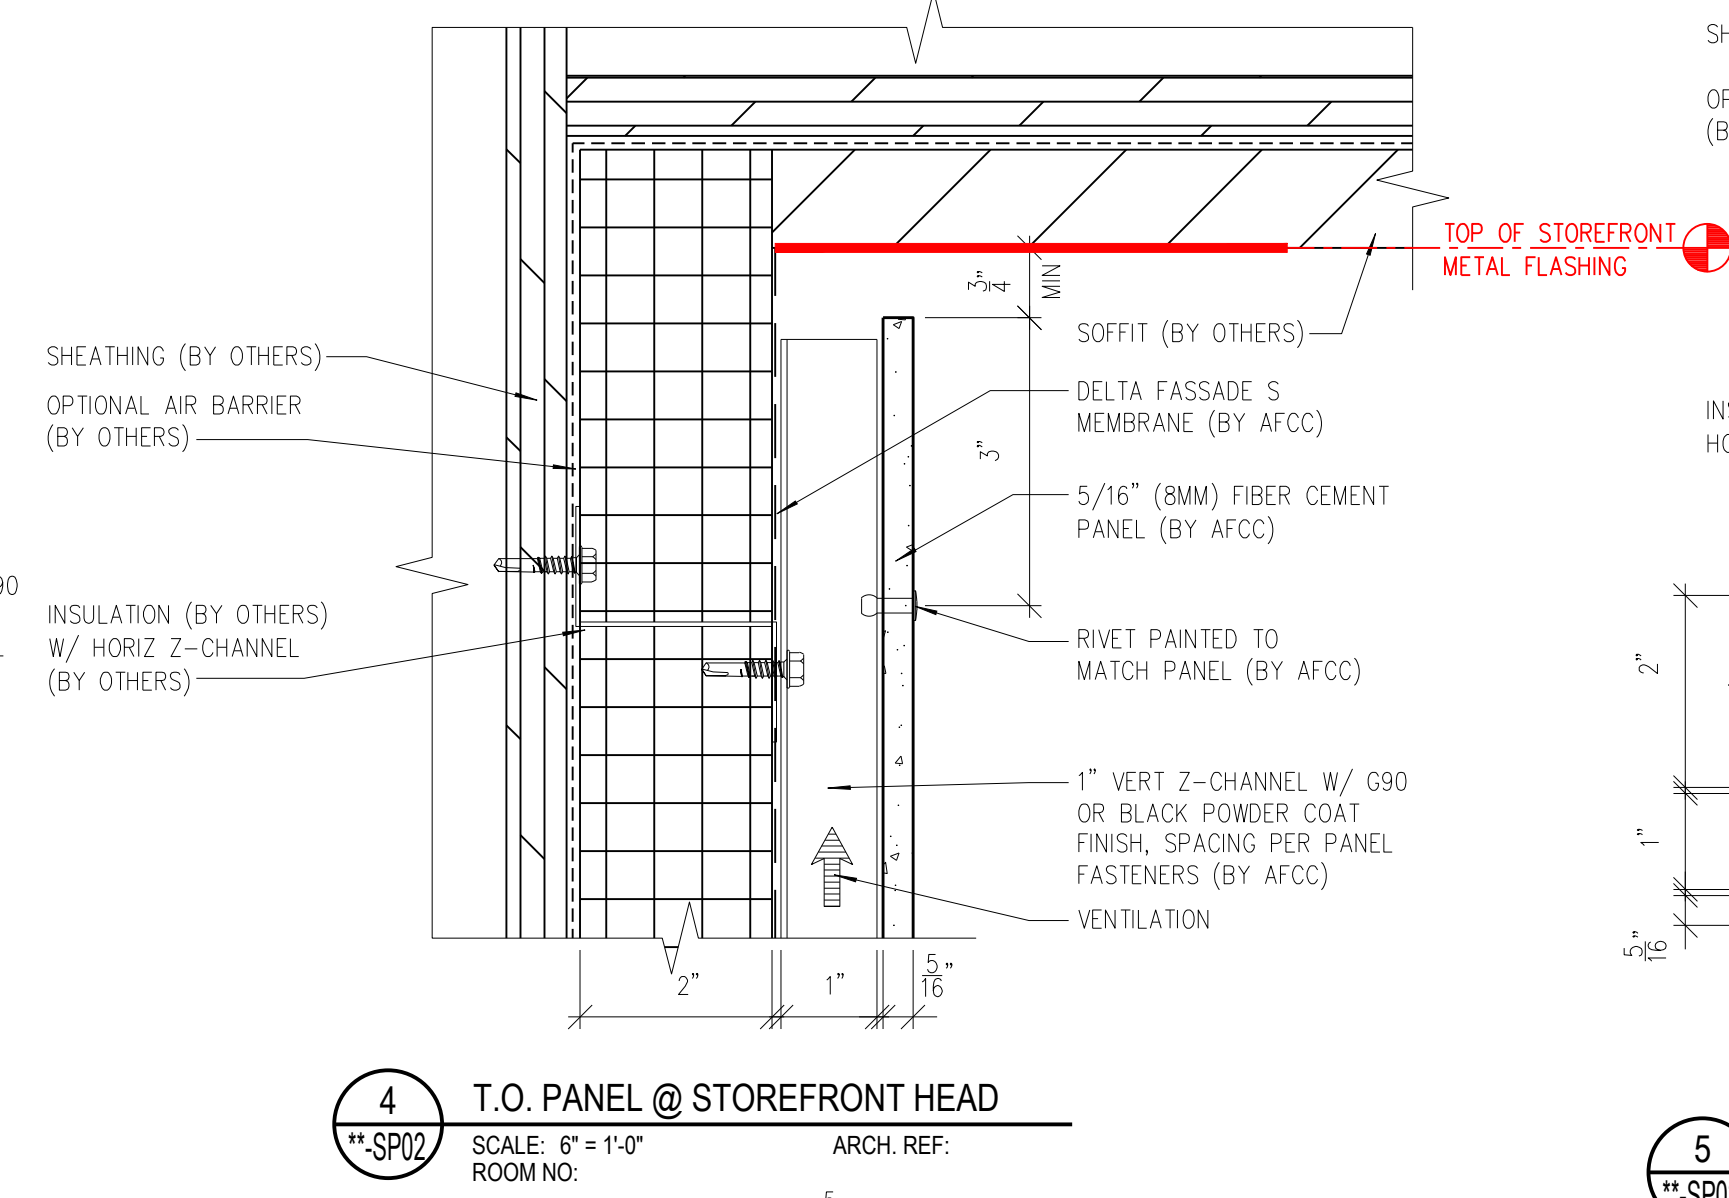

# FIELD MEASUREMENT STANDARDS - SAMPLE PROJECT FOR INSTALLER USE ONLY - ELEVATIONS SHOWN ARE NOT FOR FABRICATION

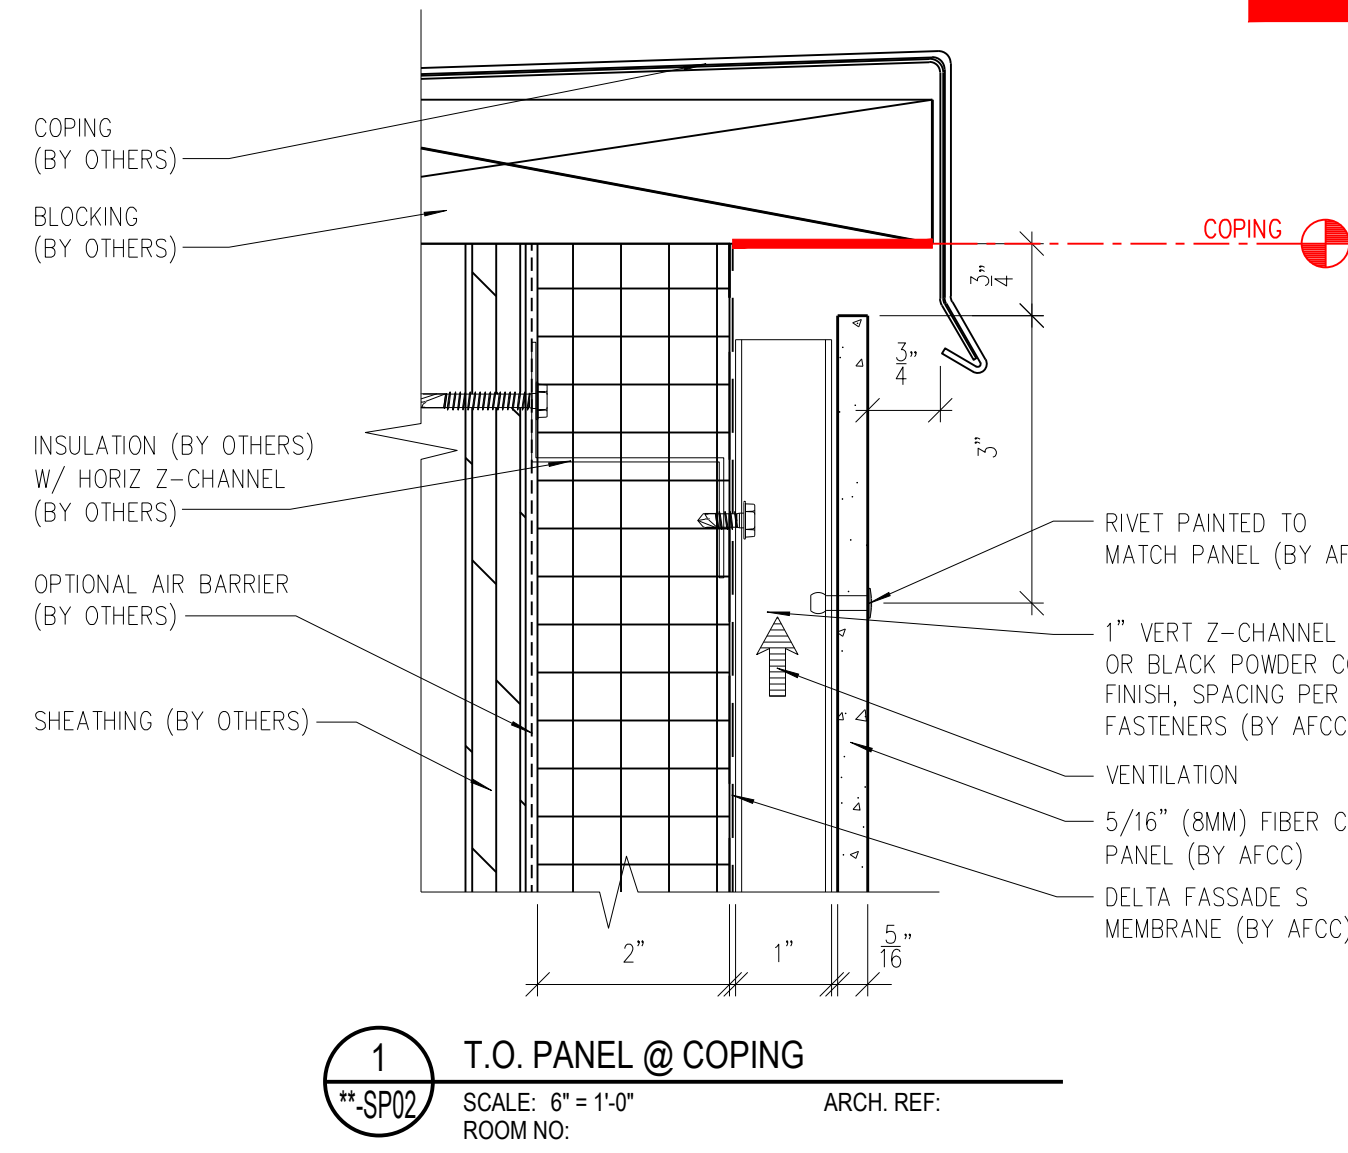

NOTE:  
MARK SPECIFIC POINT ON DETAILS THAT  
FIELD DIMENSIONS WERE MEASURED TO  
(RED LINE IS ALL THAT IS NECESSARY).

NOTE:  
WALL ASSEMBLY SHOWN  
IN DETAILS MUST BE  
APPROVED BY  
STRUCTURAL ENGINEER.

0	DATED	SHOP DRAWINGS



**Project Name**  
**Project Address**  
**AMERICAN FIBER CEMENT CORPORATION - Fiber Cement Panel Layout**


SAMPLE PROJECT  
SECTION DETAILS

AFC Project No.: AFAF#  
Scale: AS NOTED Drawn By: DR


**\*\*SP02**

# FIELD MEASUREMENT STANDARDS - SAMPLE PROJECT


## FOR INSTALLER USE ONLY - ELEVATIONS SHOWN ARE NOT FOR FABRICATION

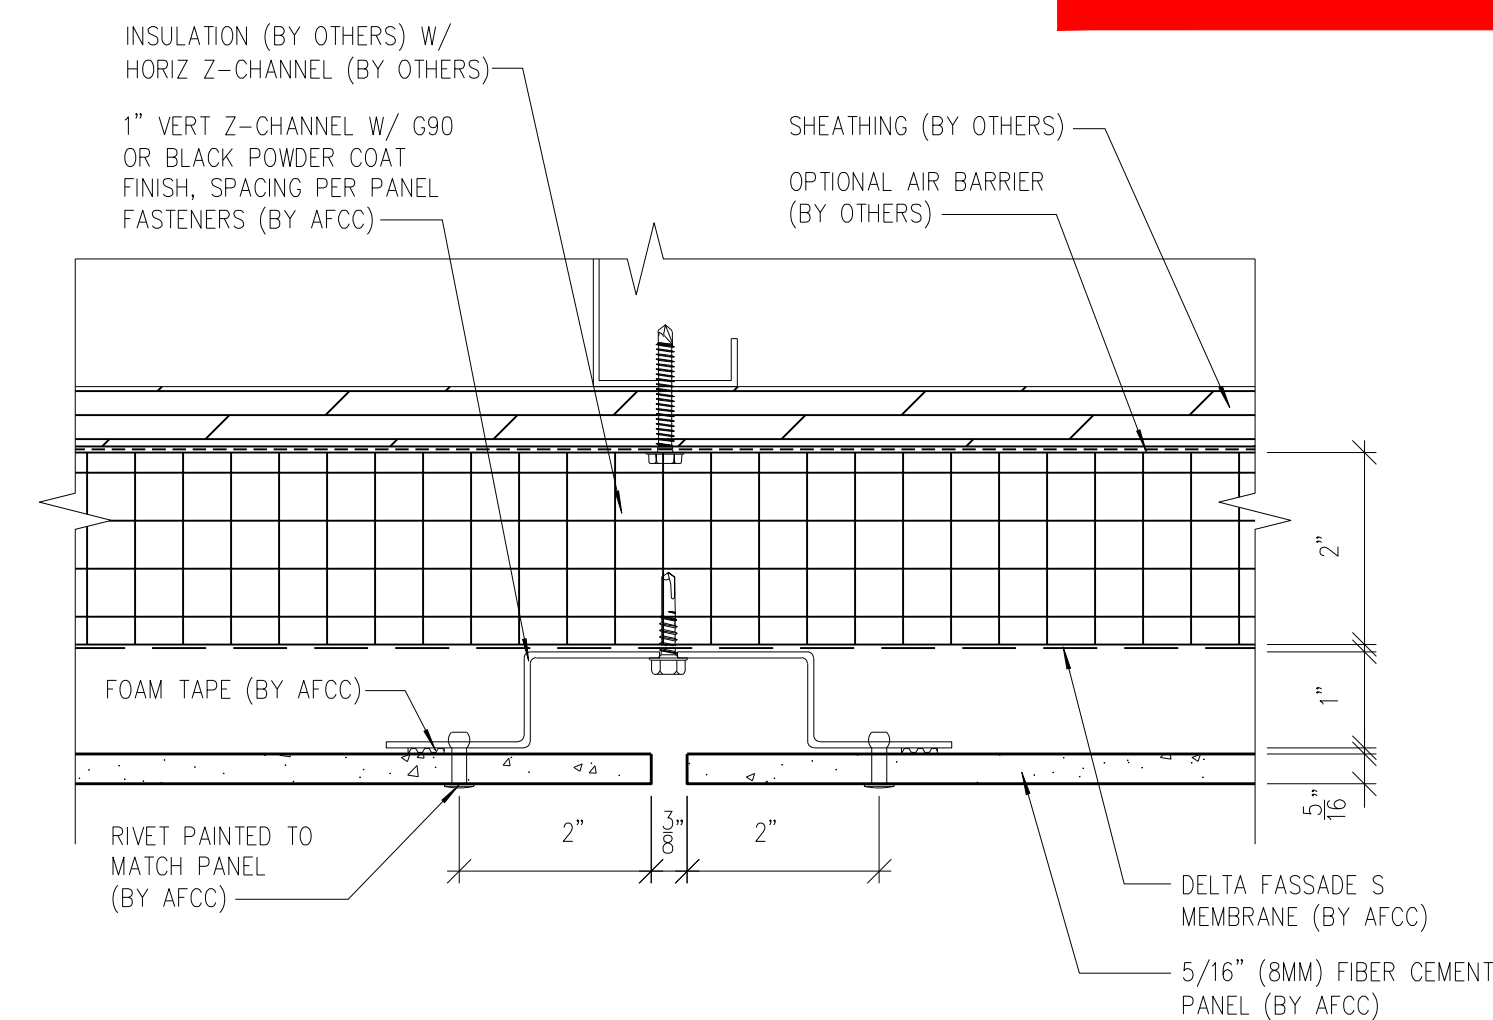


**1A** DETAIL @ VERTICAL JOINT (OPTION 1)  
 \*\*SP03 SCALE: 6" = 1'-0" ARCH. REF. ROOM NO.

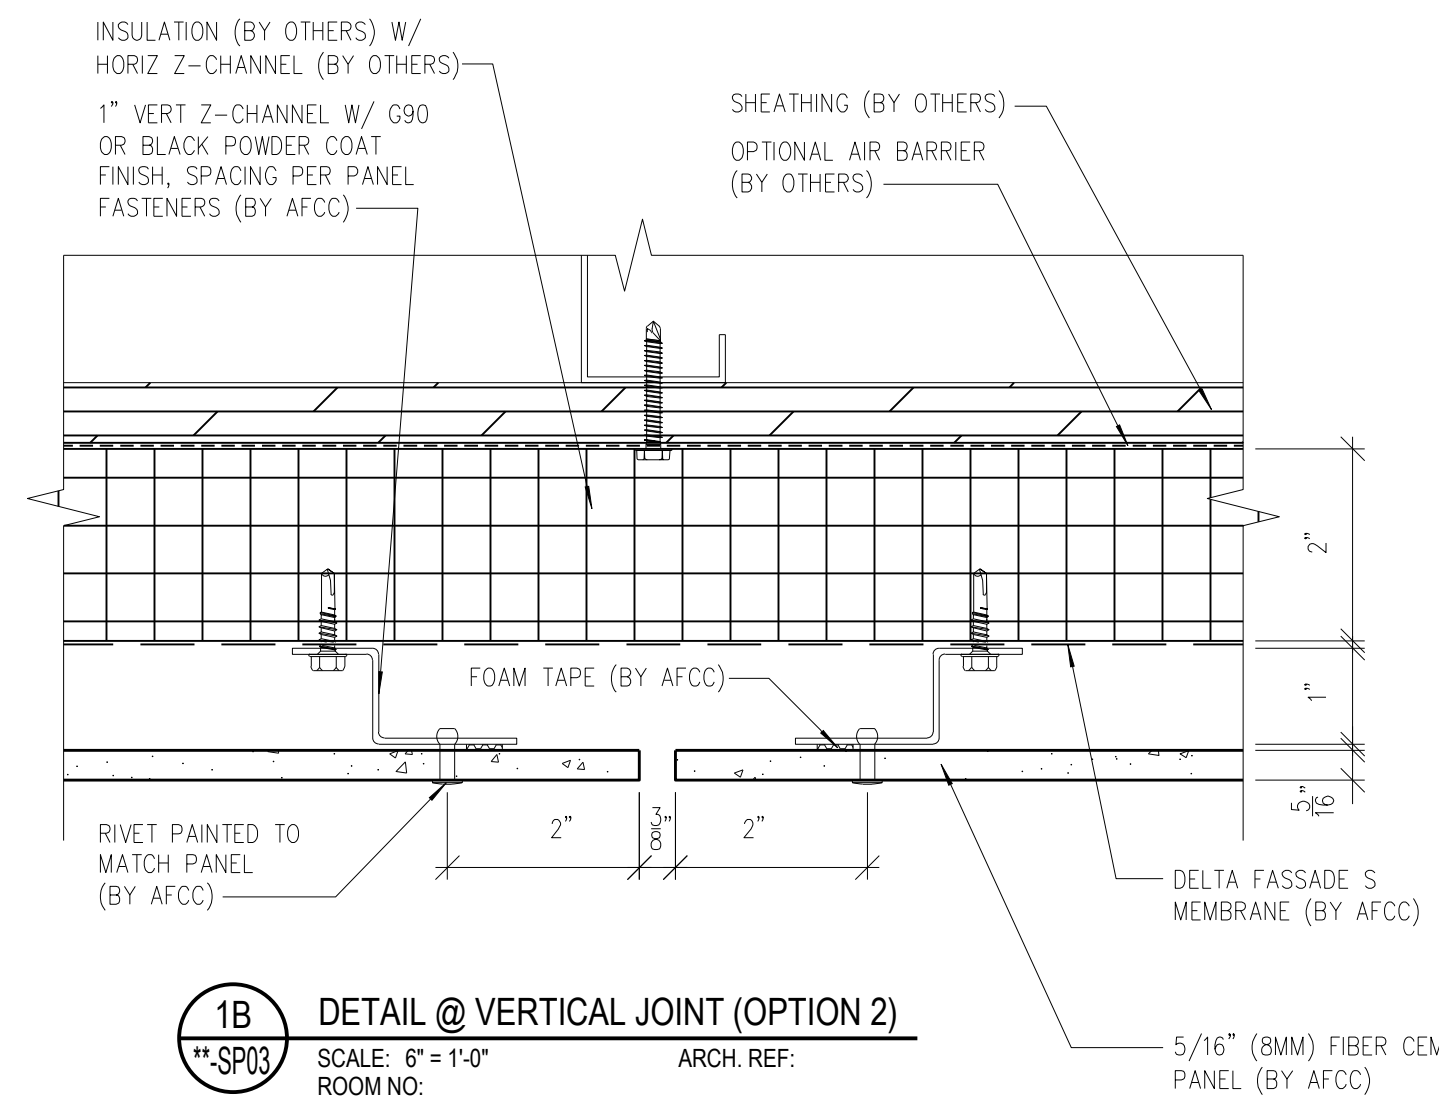


**1B** DETAIL @ VERTICAL JOINT (OPTION 2)  
 \*\*SP03 SCALE: 6" = 1'-0" ARCH. REF. ROOM NO.

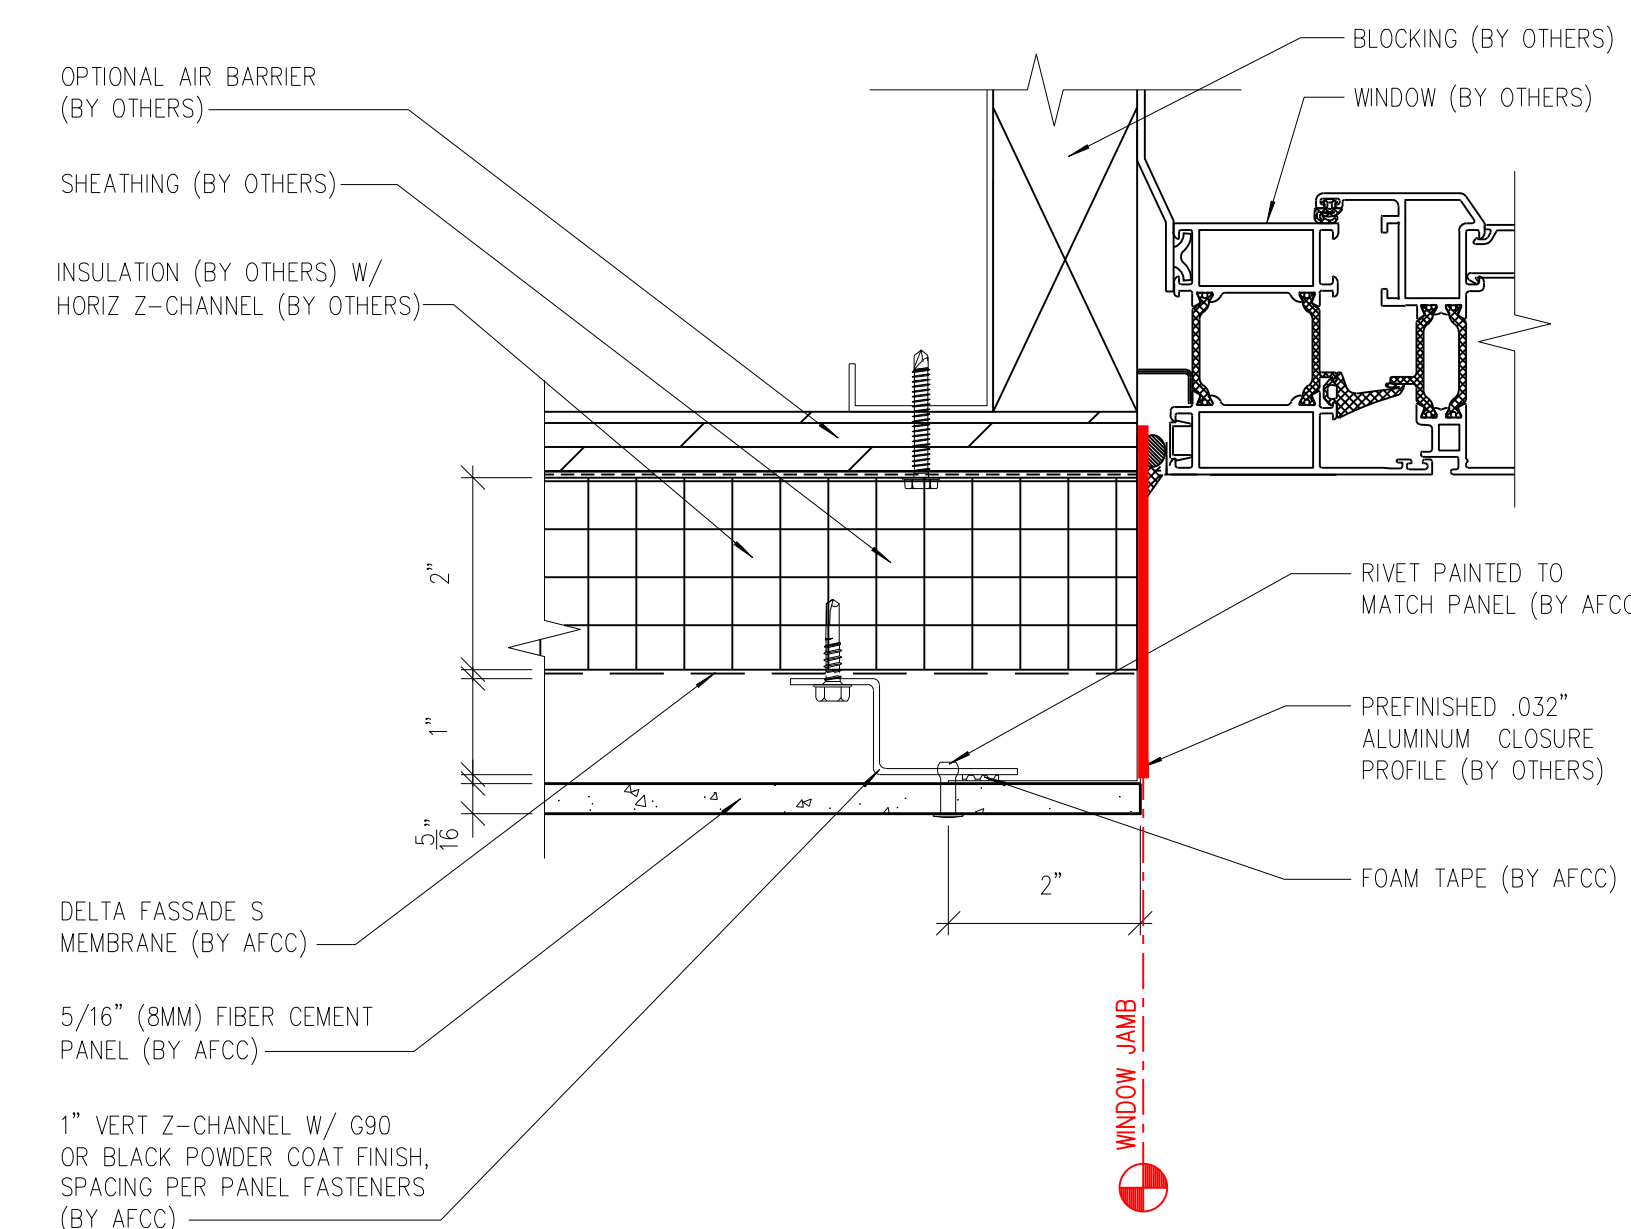


**2** TYPICAL DETAIL @ WINDOW JAMB  
 \*\*SP03 SCALE: 6" = 1'-0" ARCH. REF. ROOM NO.

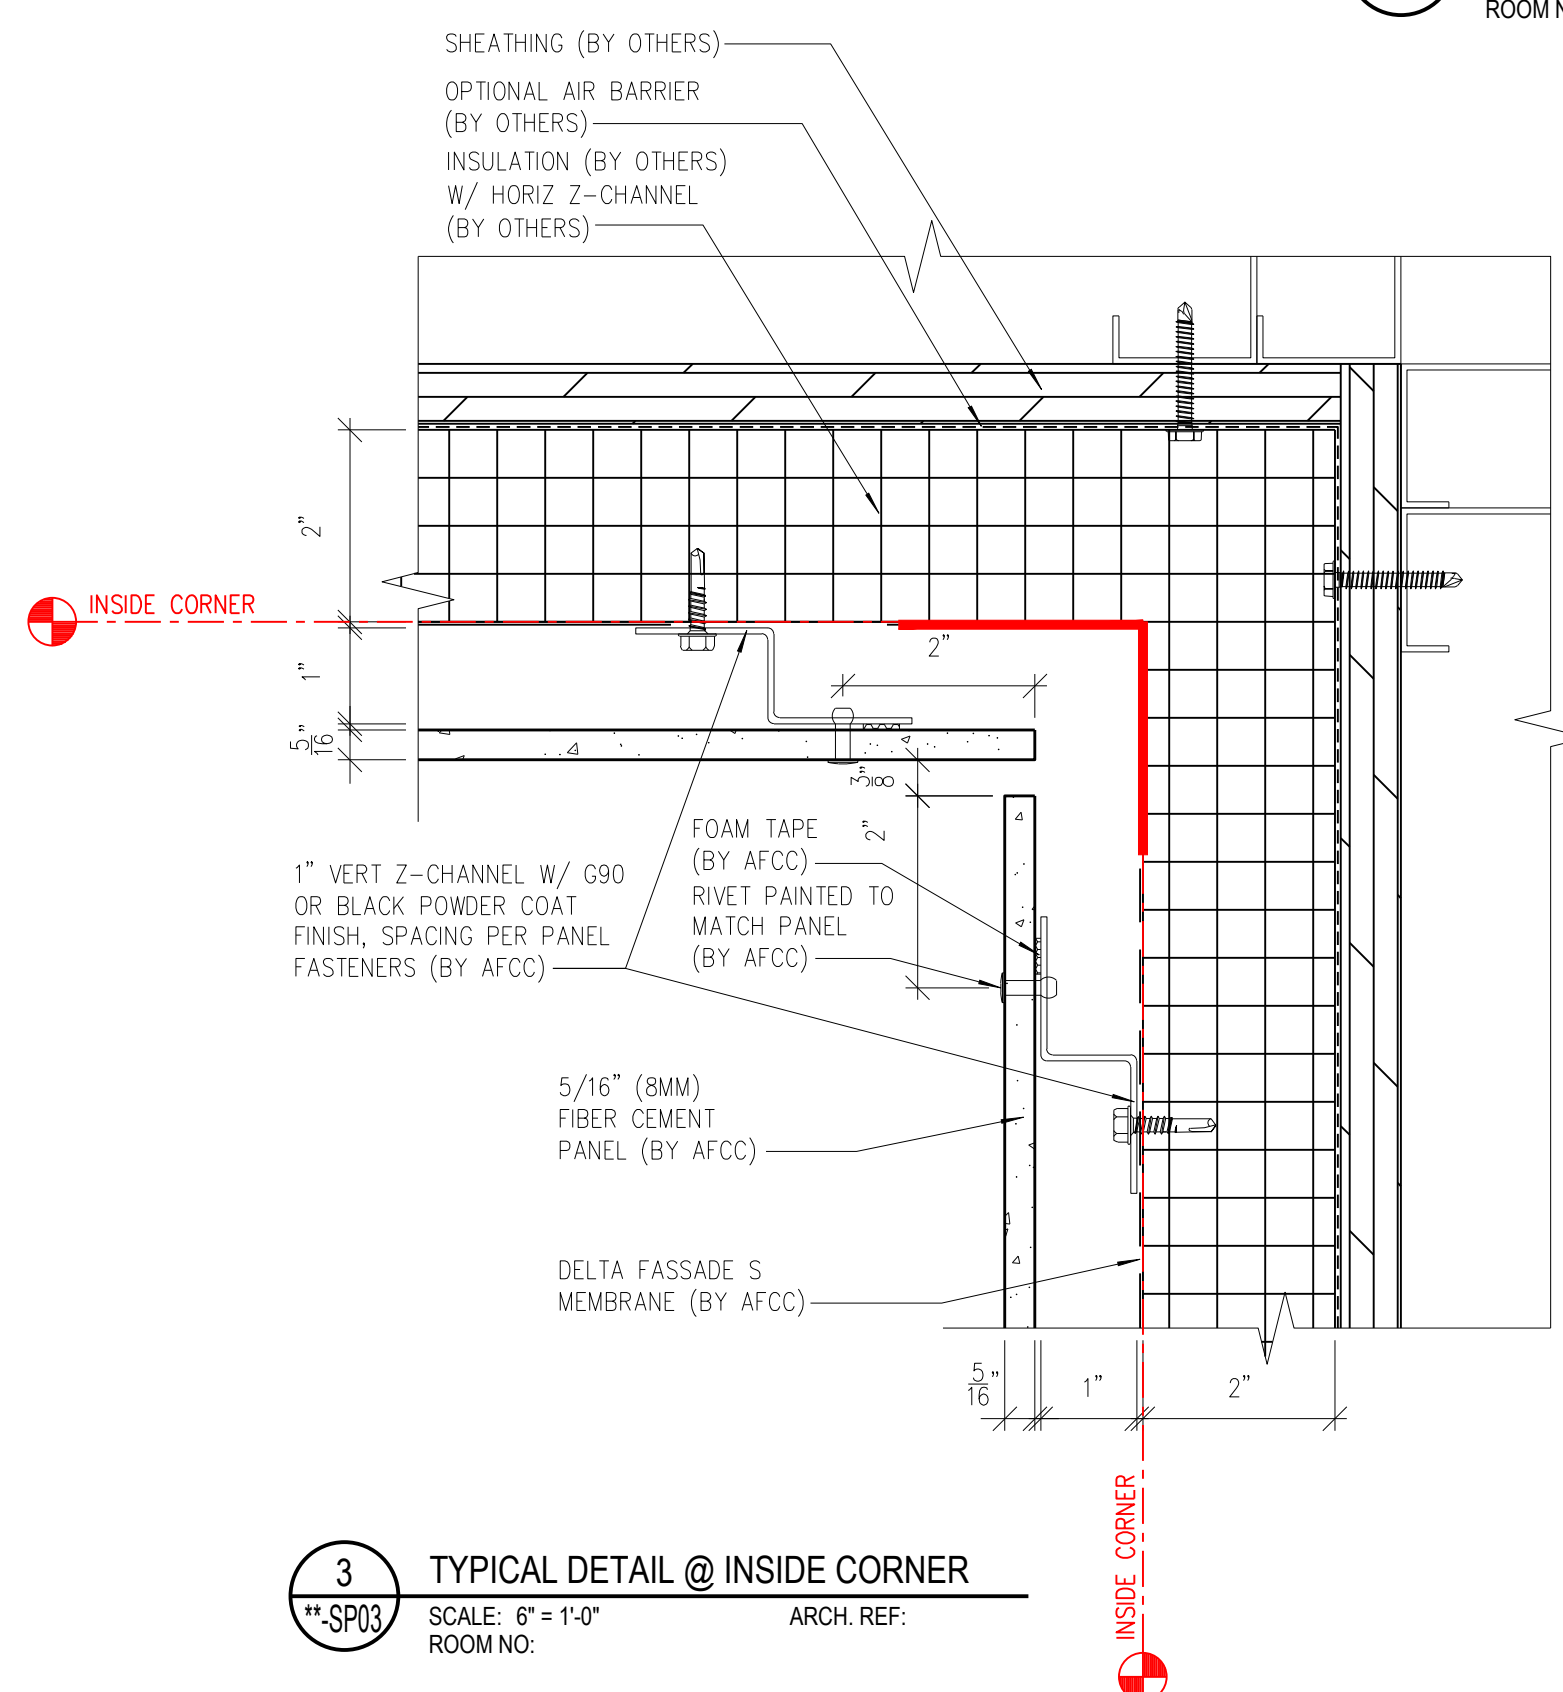


**3** TYPICAL DETAIL @ INSIDE CORNER  
 \*\*SP03 SCALE: 6" = 1'-0" ARCH. REF. ROOM NO.

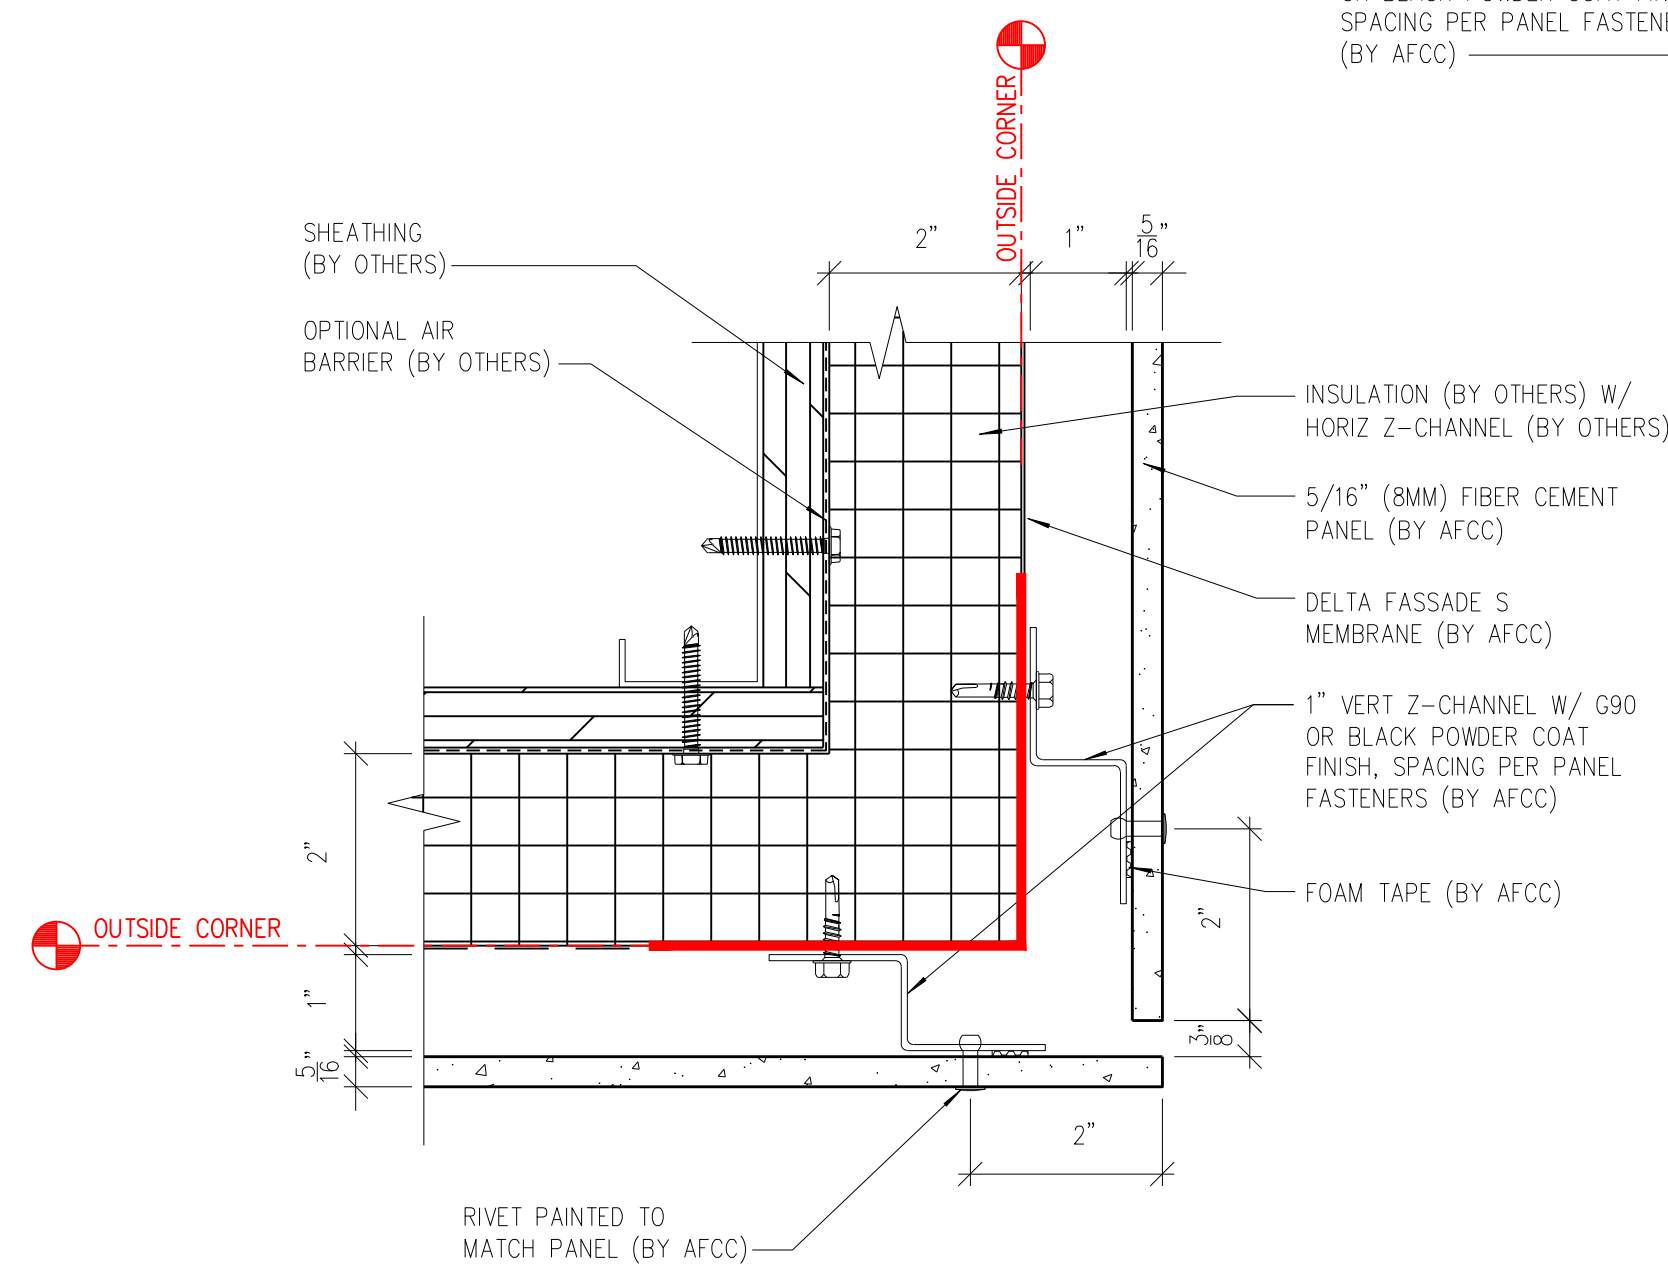

**4** TYPICAL DETAIL @ OUTSIDE CORNER  
 \*\*SP03 SCALE: 6" = 1'-0" ARCH. REF. ROOM NO.

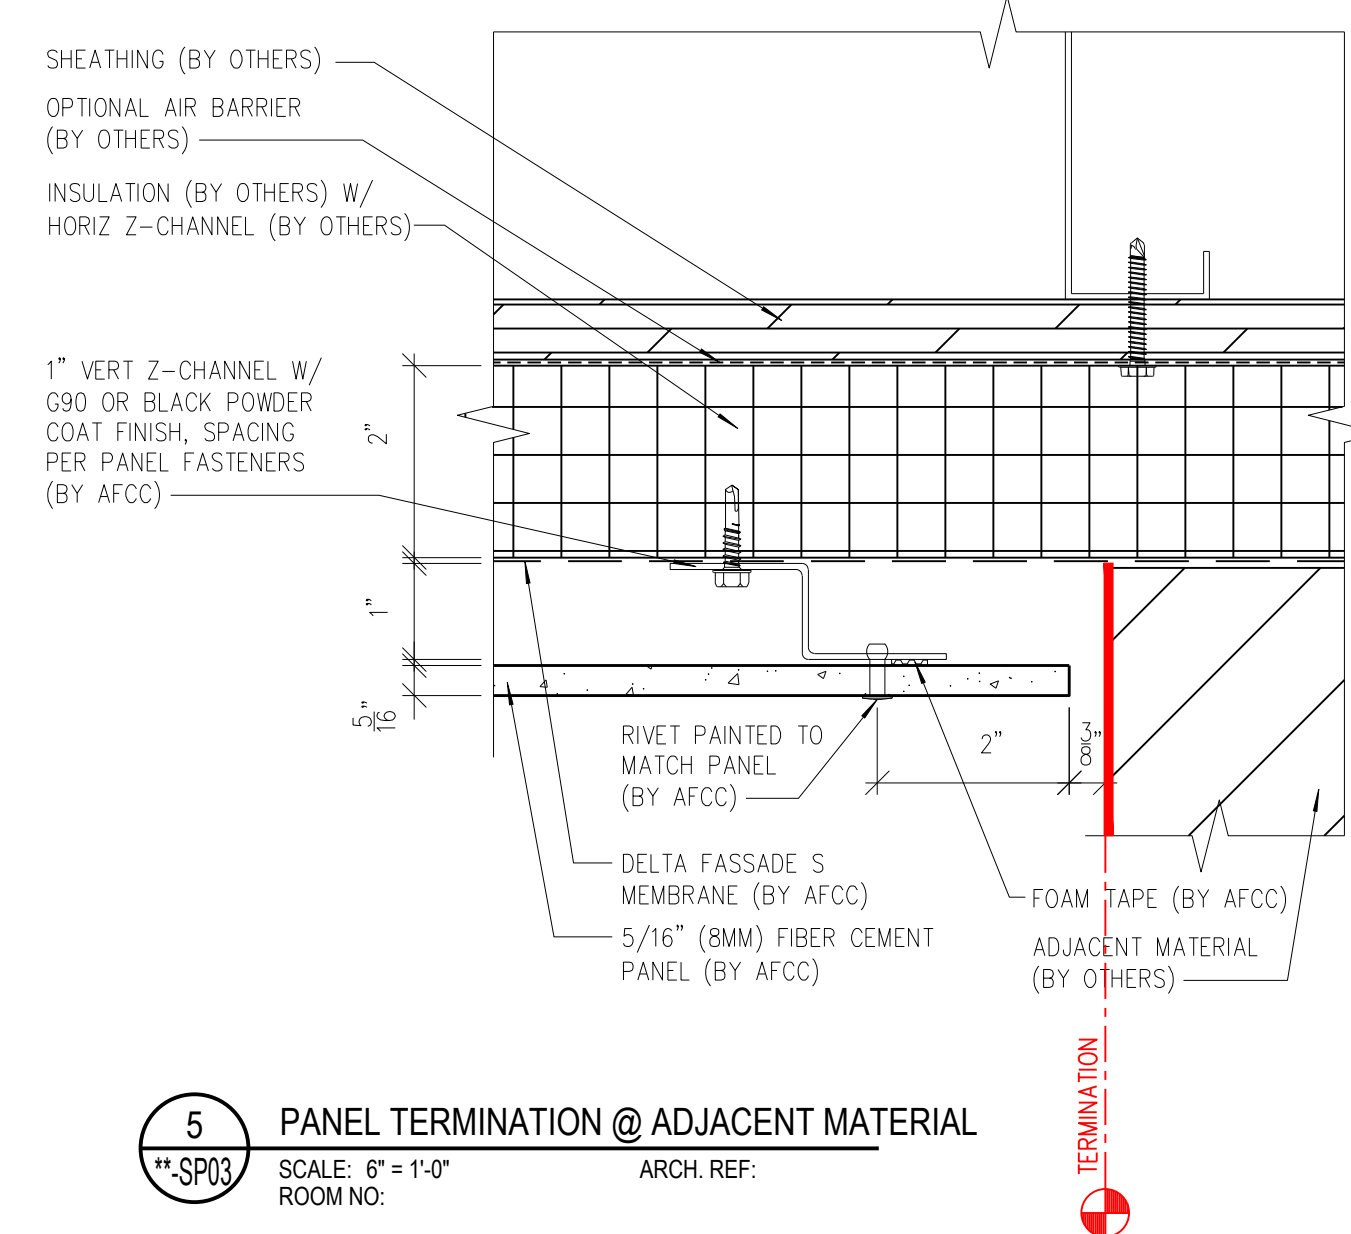

**5** PANEL TERMINATION @ ADJACENT MATERIAL  
 \*\*SP03 SCALE: 6" = 1'-0" ARCH. REF. ROOM NO.

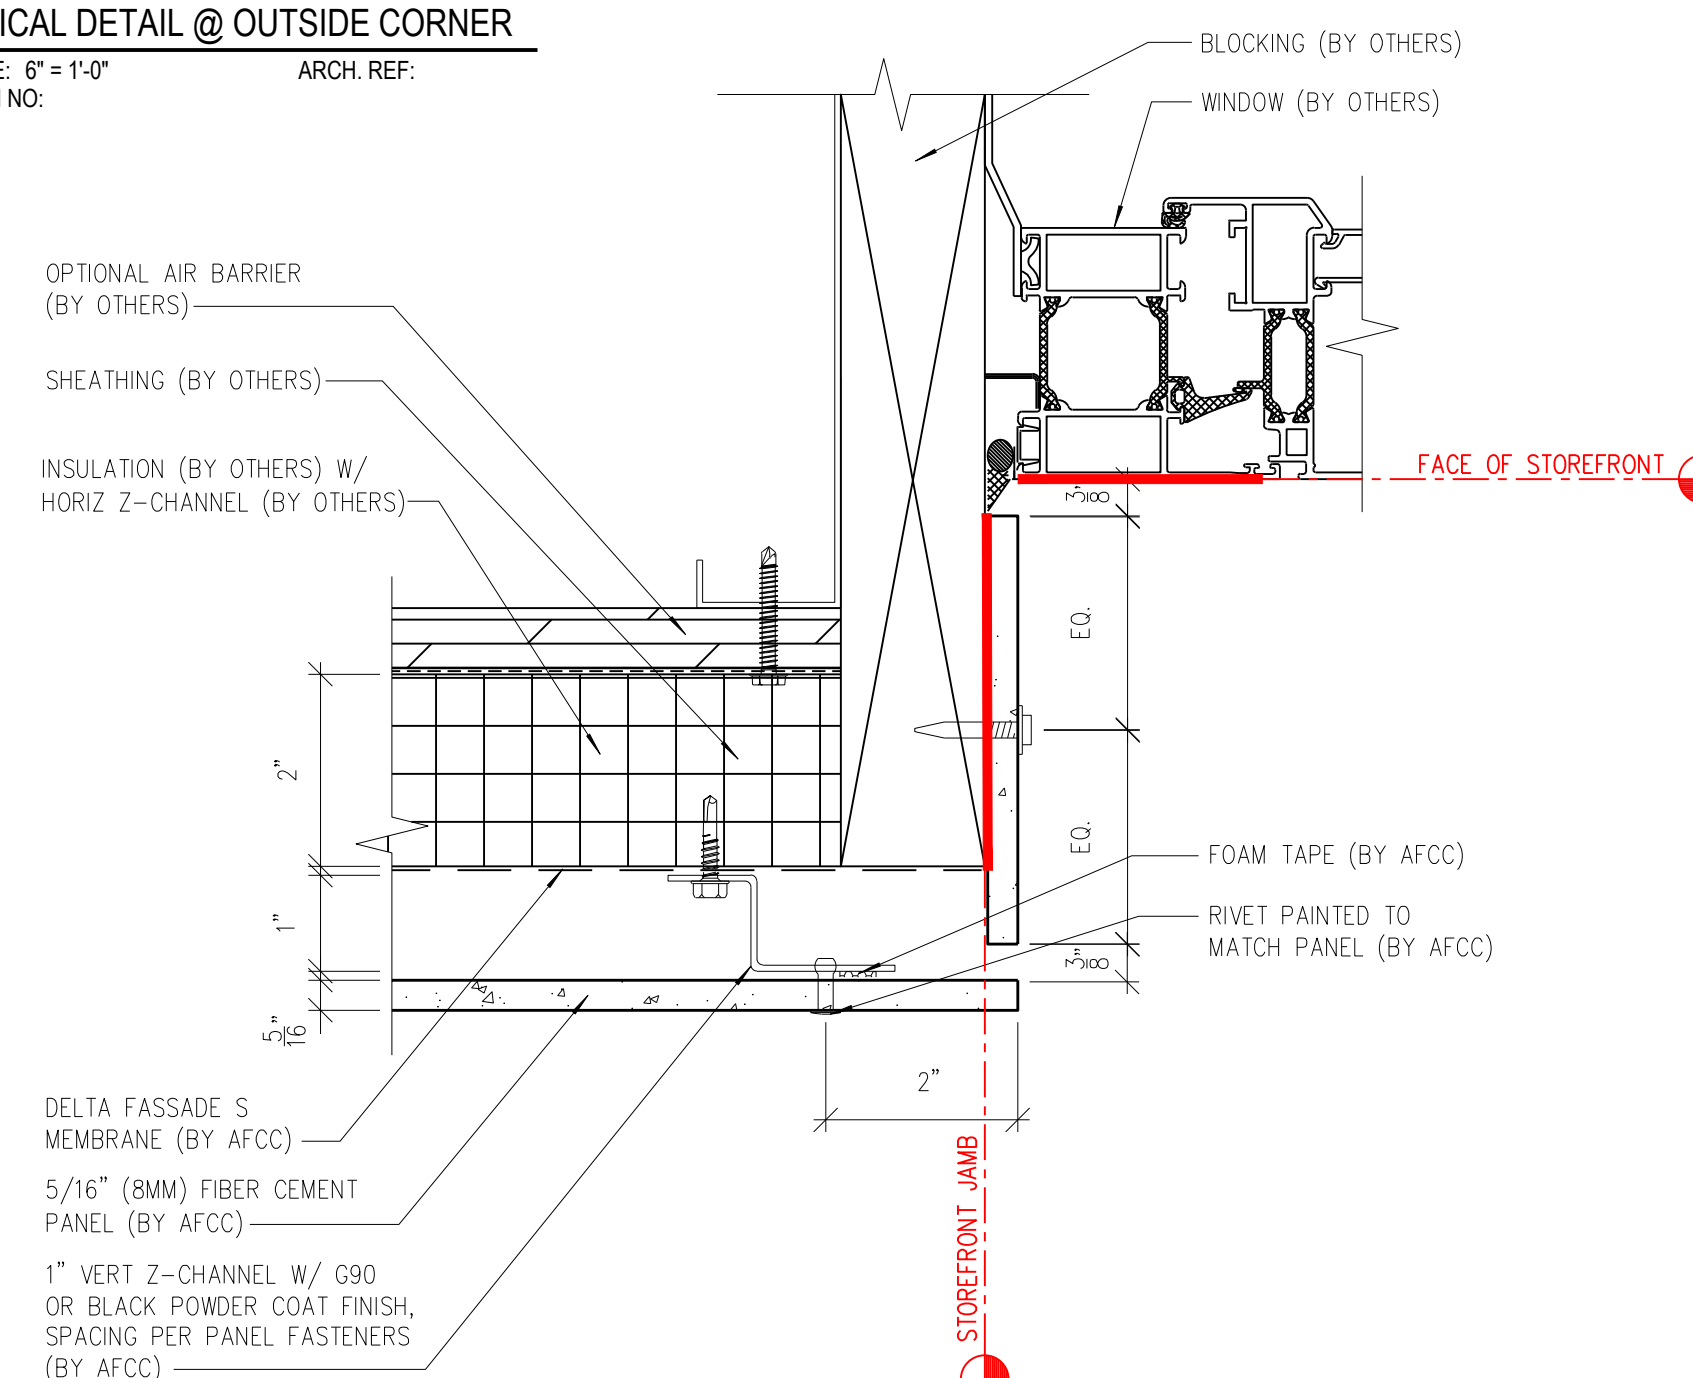

**6** TYPICAL DETAIL @ F.C.P. WINDOW JAMB  
 \*\*SP03 SCALE: 6" = 1'-0" ARCH. REF. ROOM NO.

**NOTE:**  
 MARK SPECIFIC POINT ON DETAILS THAT FIELD DIMENSIONS WERE MEASURED TO (RED LINE IS ALL THAT IS NECESSARY).

NOTE:  
 WALL ASSEMBLY SHOWN IN DETAILS MUST BE APPROVED BY STRUCTURAL ENGINEER.

0	DATE	SHOP DRAWINGS



**Project Name**  
**Project Address**  
**AMERICAN FIBER CEMENT CORPORATION - Fiber Cement Panel Layout**

SAMPLE PROJECT  
 PLAN DETAILS

AFCC Project No.: AFAP#  
 Scale: AS NOTED Drawn By: DR

**\*\*SP03**